




AVENUE
WEST

Suite 600 | 9,056 SF

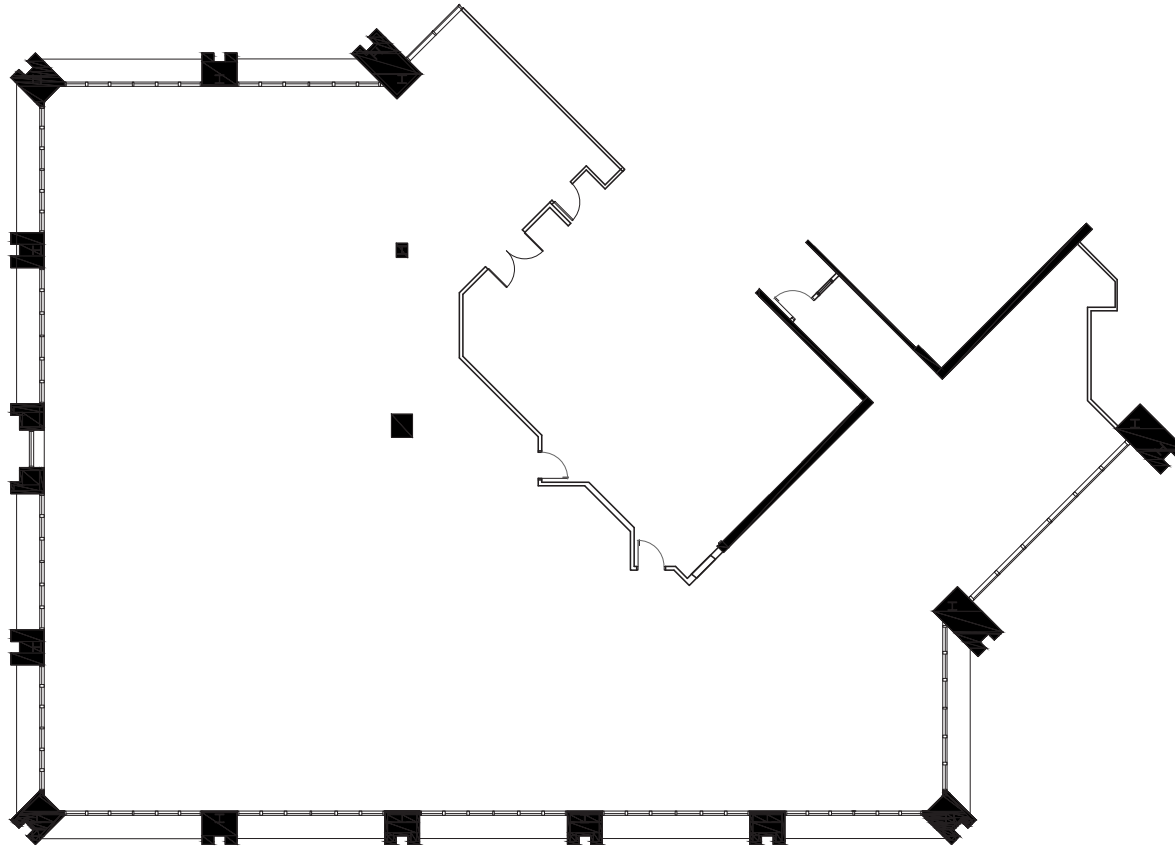

For more information, please contact:

William B. Lucas
Managing Director
Direct: +1 303 312 4239
bill.lucas@cushwake.com

Luke Myles
Associate
+1 303 813 6406
luke.myles@cushwake.com

Nathan J. Bradley
Managing Director
+1 303 813 6444
nate.bradley@cushwake.com

W. Ryan Stout
Managing Director
+1 303 813 6448
ryan.stout@cushwake.com

Zachary T. Williams
Director
+1 303 813 6474
zach.williams@cushwake.com