


# BELLEVIEW

CORPORATE PLAZA I & II

THE  
RMR  
GROUP

## Suite 280 - 2,251 RSF Spec Suite

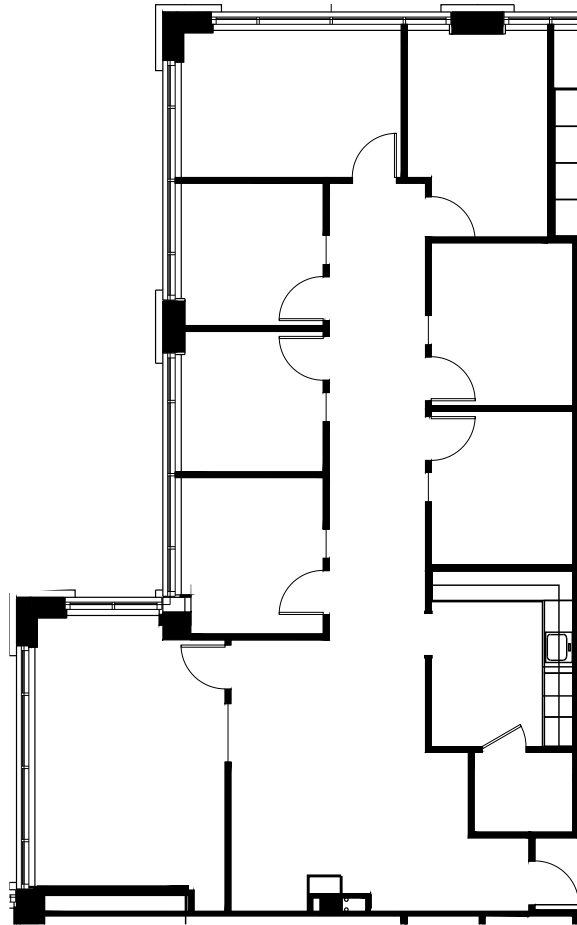

TOUR SUITE

W. Ryan Stout  
303.813.6448  
ryan.stout@cushwake.com

Nathan J. Bradley  
303.813.6444  
nate.bradley@cushwake.com

Zachary T. Williams  
303.813.6474  
zach.williams@cushwake.com

