


BELLEVIEW

CORPORATE PLAZA I & II

THE
RMR
GROUP

Suite 520 - 1,672 RSF As-Built

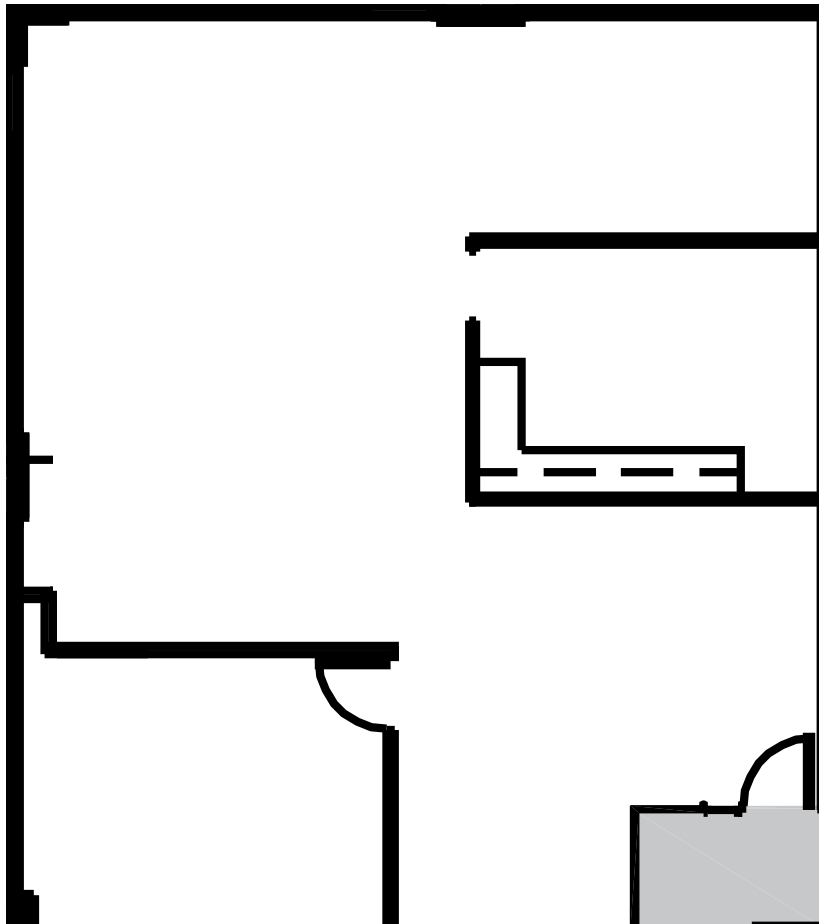

W. Ryan Stout
303.813.6448
ryan.stout@cushwake.com

Nathan J. Bradley
303.813.6444
nate.bradley@cushwake.com

Zachary T. Williams
303.813.6474
zach.williams@cushwake.com

