


## AS-BUILT

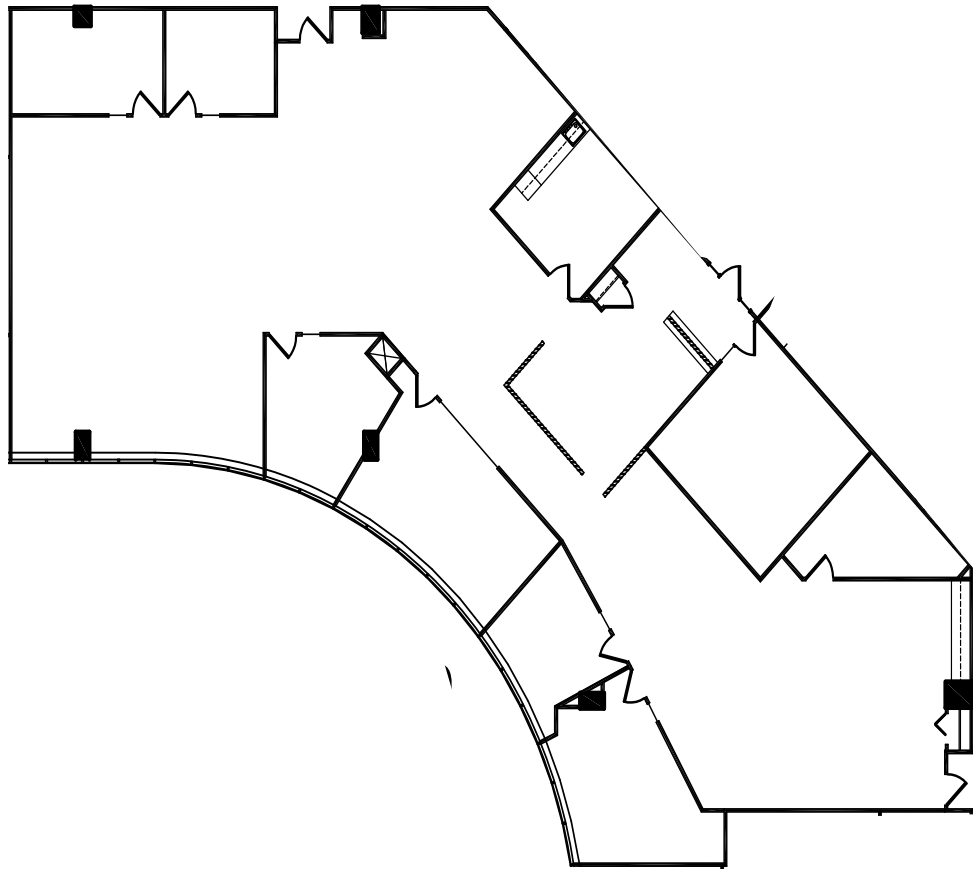

**SUITE 203**  
**5,914 RSF**