


384

INVERNESS

Suite 250
6,896 RSF

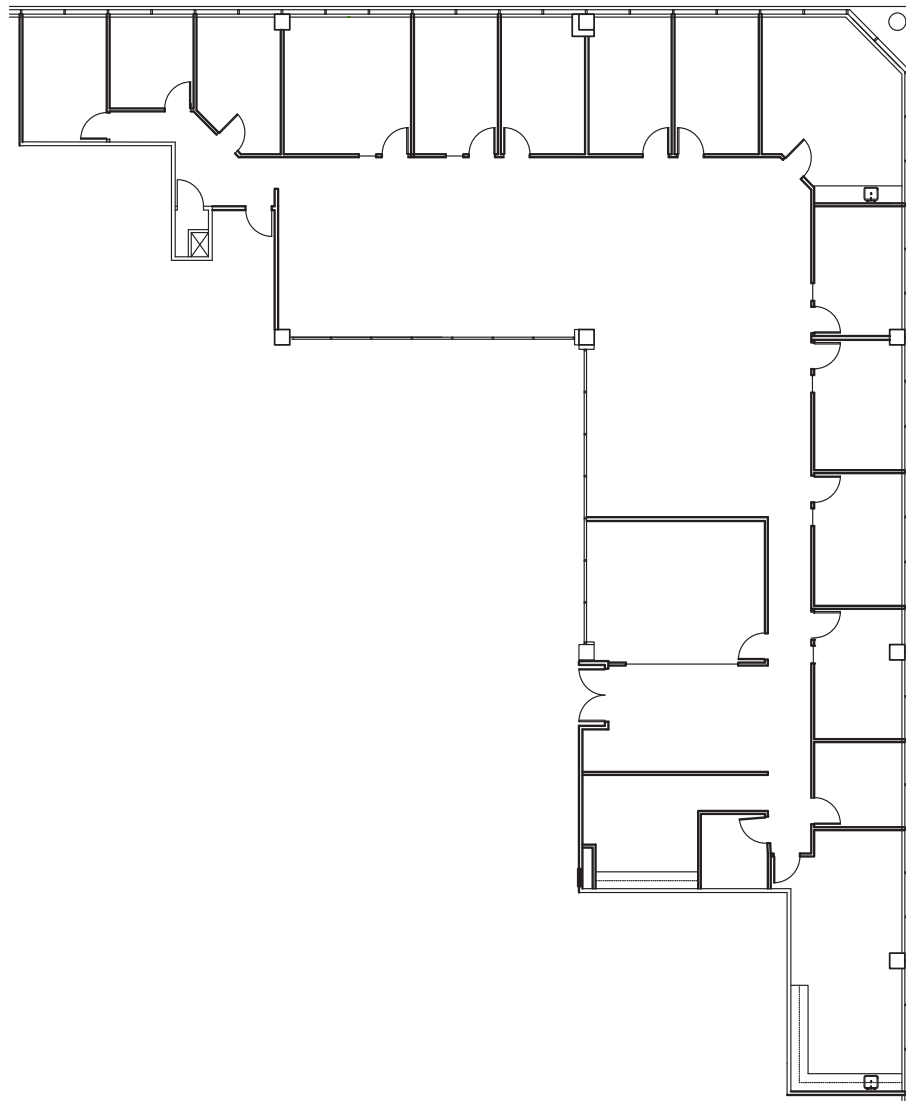

PREMIUM OFFICE FOR LEASE

Nathan J. Bradley
303.813.6444
nate.bradley@cushwake.com

W. Ryan Stout
303.813.6448
ryan.stout@cushwake.com

Zachary T. Williams
303.813.6474
zach.williams@cushwake.com

Kiley Crews
303.312.4219
kiley.crews@cushwake.com

