




Highland Place II

9110 E NICHOLS AVE | CENTENNIAL, CO 80112



CENTREPOINT
PROPERTIES

Suite 100 - 1,744 RSF

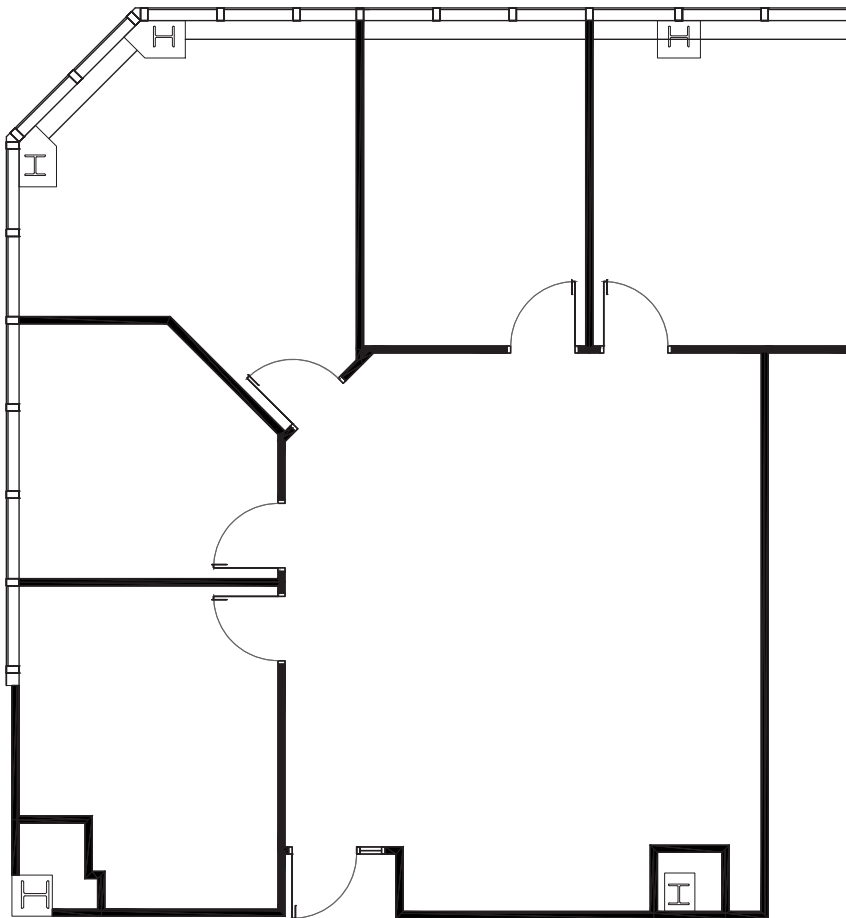

NATE BRADLEY
303 813 6444
nate.bradley@cushwake.com

RYAN STOUT
303 813 6448
ryan.stout@cushwake.com

ZACH WILLIAMS
303 813 6474
zach.williams@cushwake.com

