


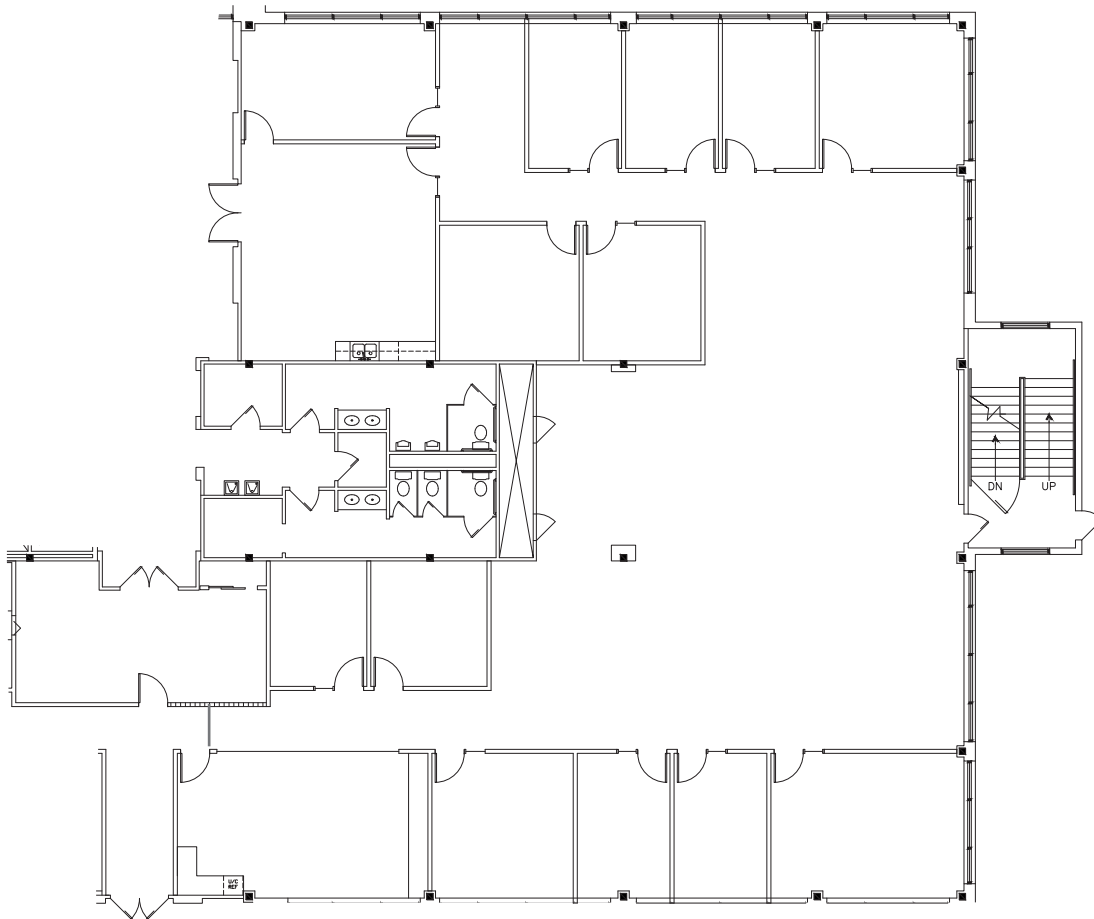

**Suite 200**  
**7,715 RSF**



**6377 S Revere Pkwy, Centennial, CO 80111**

**W. Ryan Stout**  
303.813.6448  
ryan.stout@cushwake.com

**Zachary T. Williams**  
303.813.6474  
zach.williams@cushwake.com

**Nathan J. Bradley**  
303.813.6444  
nate.bradley@cushwake.com

