


CRESCENT

8490 East Crescent Parkway | Greenwood Village

SUITE 120
3,390 RSF
AS-BUILT

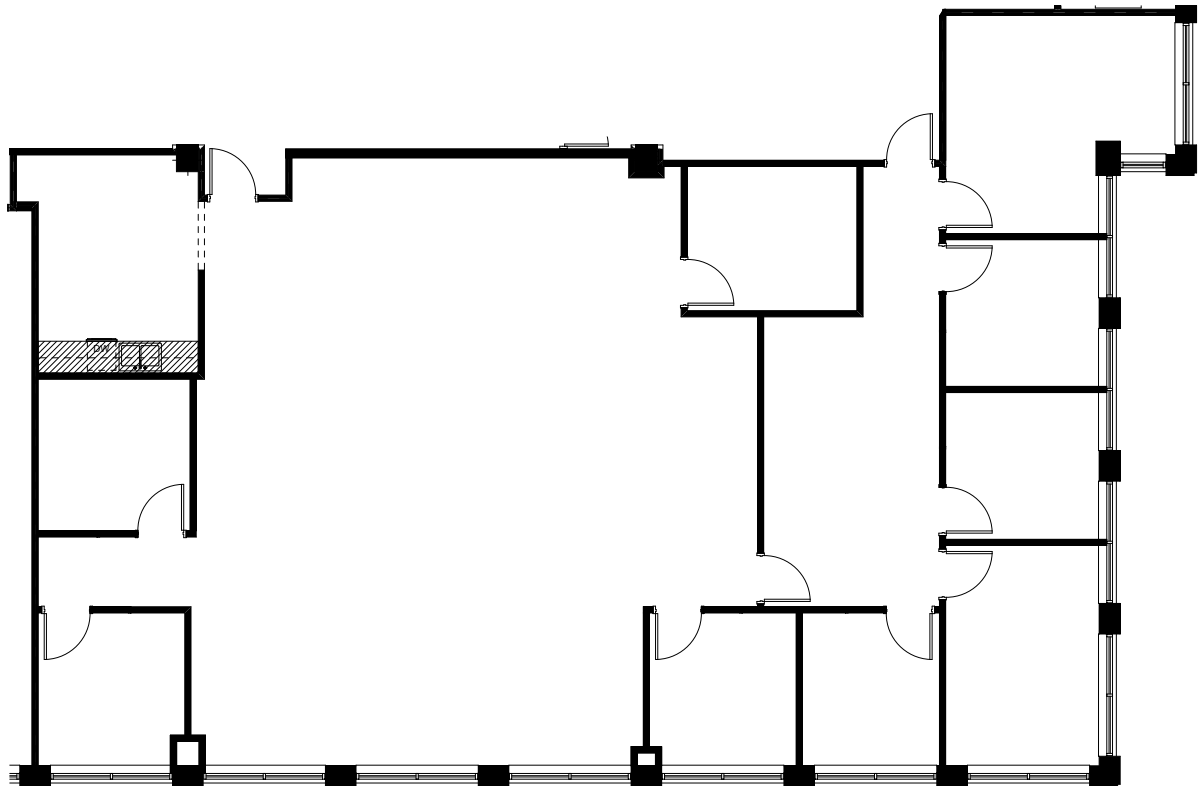

Nathan J. Bradley
303.813.6444
nate.bradley@cushwake.com

W. Ryan Stout
303.813.6448
ryan.stout@cushwake.com

Zachary T. Williams
303.813.6474
zach.williams@cushwake.com

