


# ONE LINCOLN STATION

Suite 515: 3,147 RSF

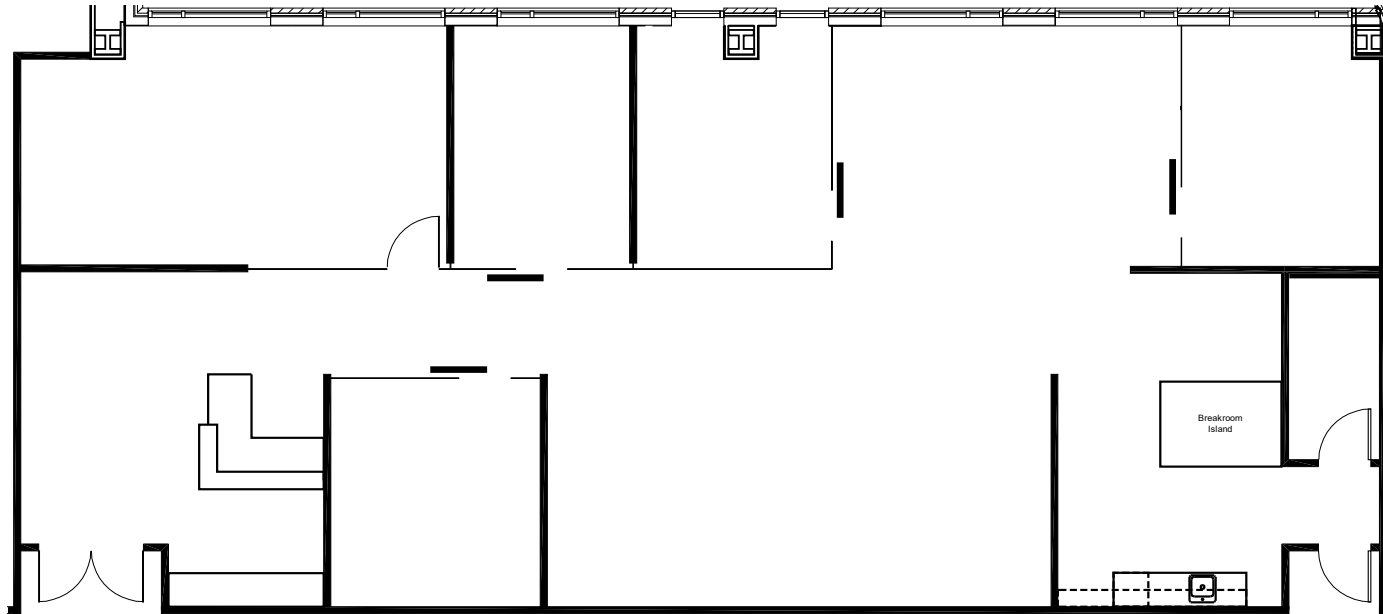

9380 Station Street, Lone Tree, Colorado 80124

**W. Ryan Stout**  
303.813.6448  
ryan.stout@cushwake.com

**Zachary T. Williams**  
303.813.6474  
zach.williams@cushwake.com

**Nathan J. Bradley**  
303.813.6444  
nate.bradley@cushwake.com

