


ONE LINCOLN STATION

Suite 200: 5,000- 25,521 RSF

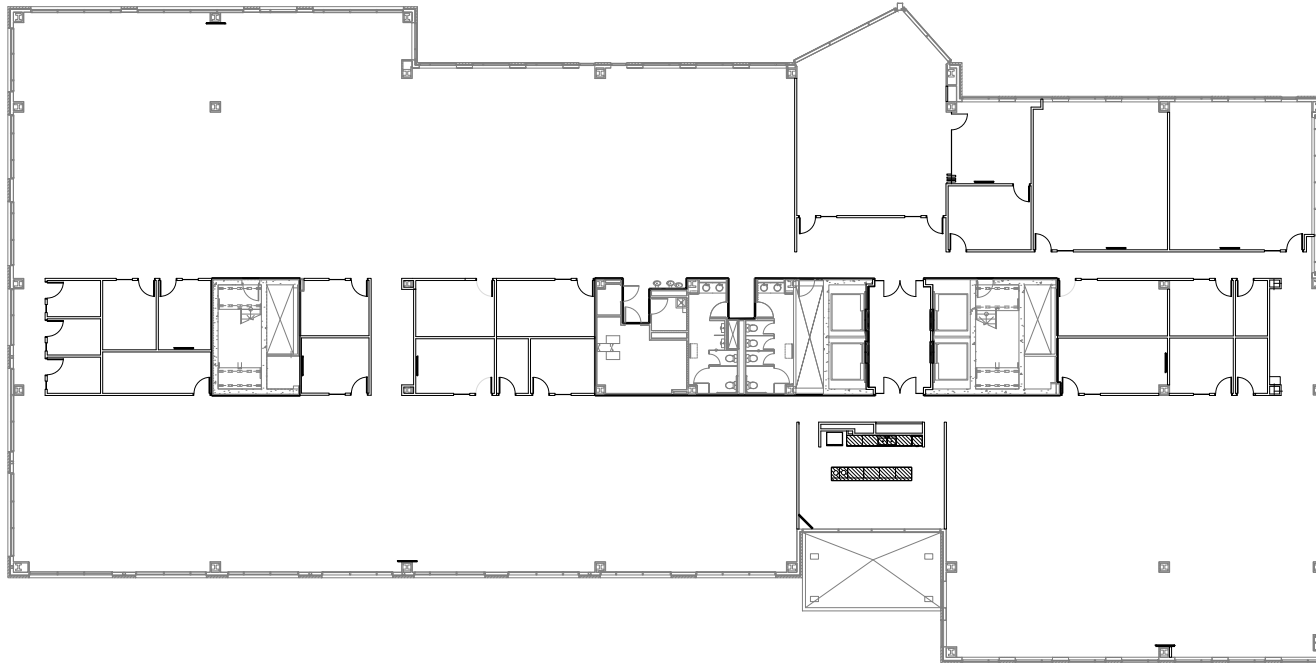

9380 Station Street, Lone Tree, Colorado 80124

W. Ryan Stout
303.813.6448
ryan.stout@cushwake.com

Zachary T. Williams
303.813.6474
zach.williams@cushwake.com

Nathan J. Bradley
303.813.6444
nate.bradley@cushwake.com

