



FIRST FLOOR AS-BUILTS

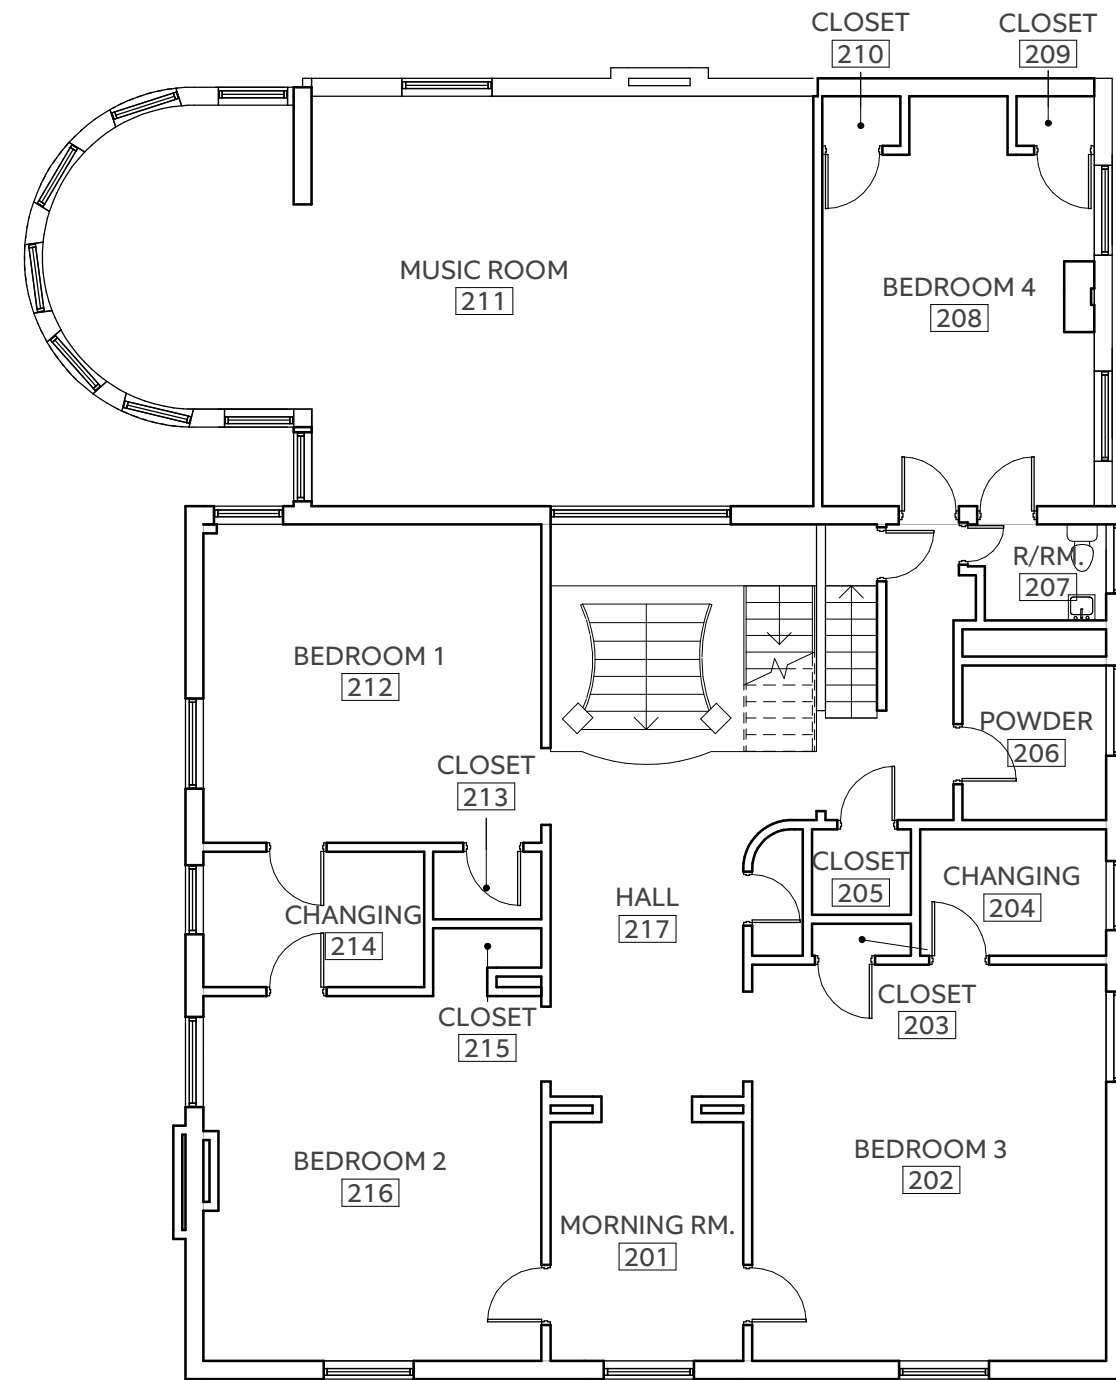

SECOND FLOOR AS-BUILTS

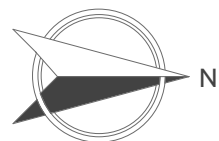

[SCALE]
3/32" = 1' - 0"


LEVEY MANSION

FIRST + SECOND FLOOR AS-BUILTS
2902 N. MERIDIAN STREET
INDIANAPOLIS, INDIANA 46208


[PROJ. #]
2021.222

[DATE | REVISION]
06.14.21 | 00




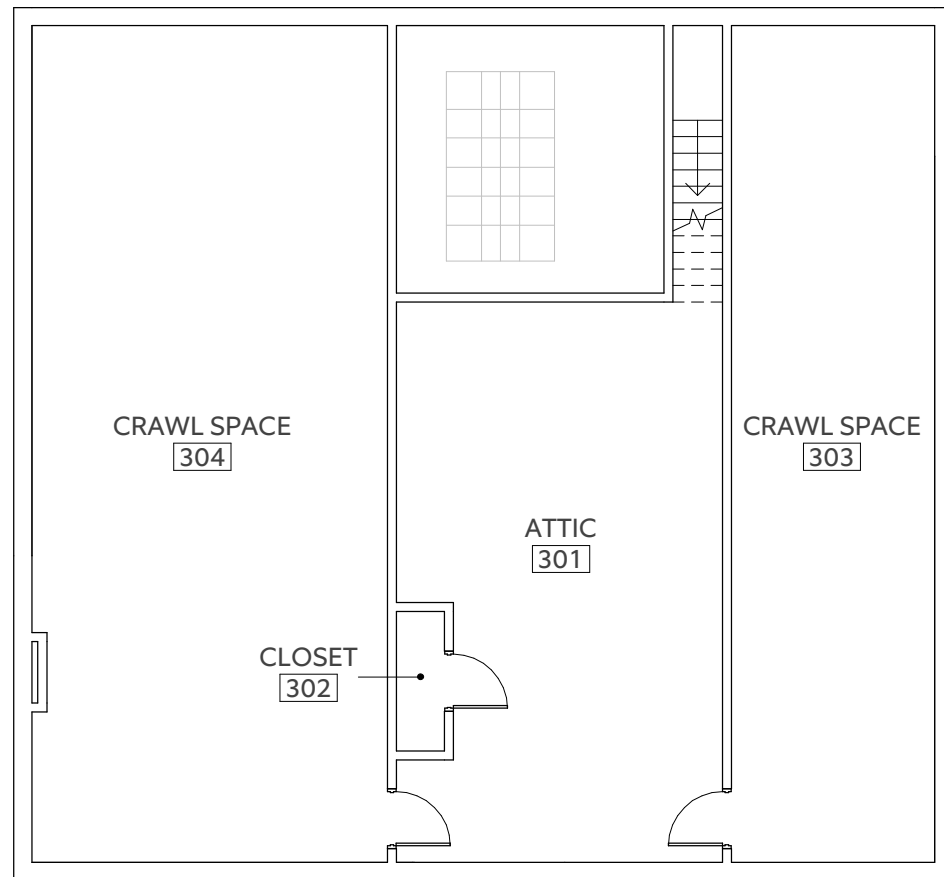

THIRD FLOOR AS-BUILTS

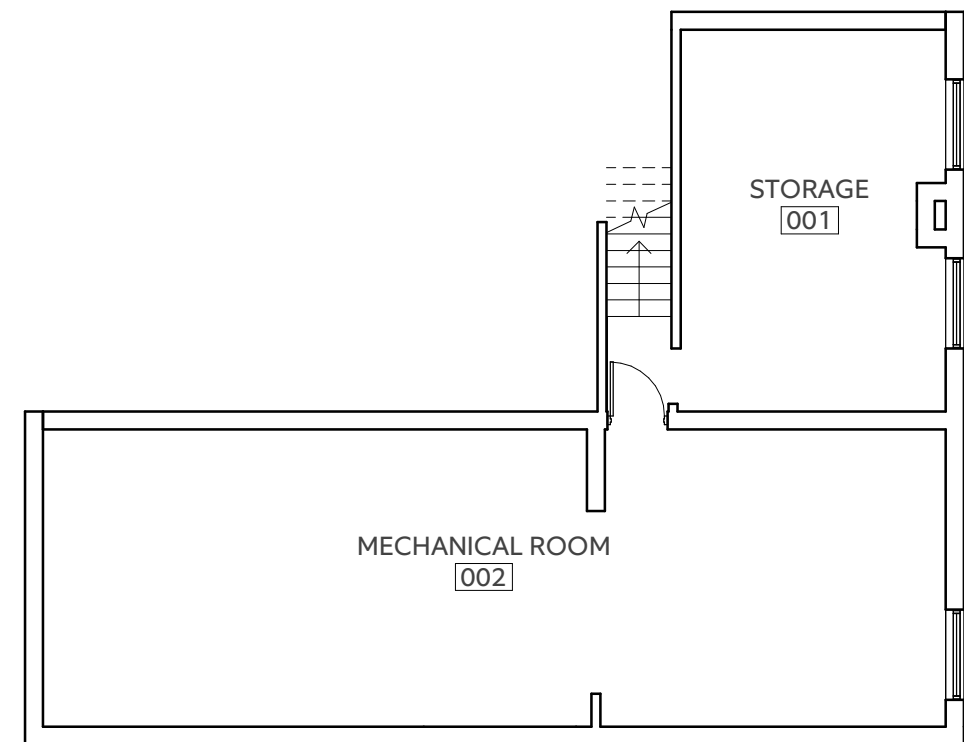

FLOOR LOWER LEVEL AS-BUILTS

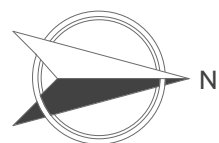

[SCALE]
3/32" = 1' - 0"

LEVEY MANSION

THIRD + FLOOR LOWER LEVEL AS-BUILTS
2902 N. MERIDIAN STREET
INDIANAPOLIS, INDIANA 46208

[PROJ. #]
2021.222

[DATE | REVISION]
06.14.21 | 00

